


	STAGE BOUNDARY
	AS-BUILT LOT ELEV (EX GROUND ELEV)
	DITCH
	DIRECTION OF FLOW
	SWALE
	CULVERT
18	LOT NUMBER
	SWALE / CULVERT INVERT



I/R	DATE	DESCRIPTION
3	2016/12/16	ISSUED FOR RECORD
2	2016/07/15	ISSUED FOR CONSTRUCTION
1	2016/04/12	ISSUED FOR ADDENDUM #1
0	2016/03/31	ISSUED FOR TENDER

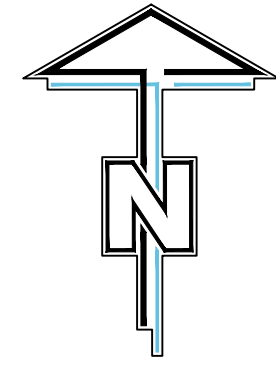

GENERAL NOTES:

- ALL DIMENSIONS AND ELEVATIONS ARE IN METRES UNLESS SPECIFIED OTHERWISE.
- ELEVATIONS SHOWN REFER TO GEODETIC DATUM.

GRACE LAKE
(NAVIGABLE)

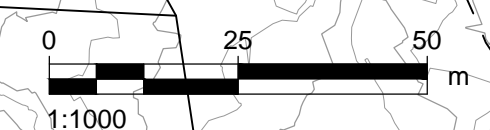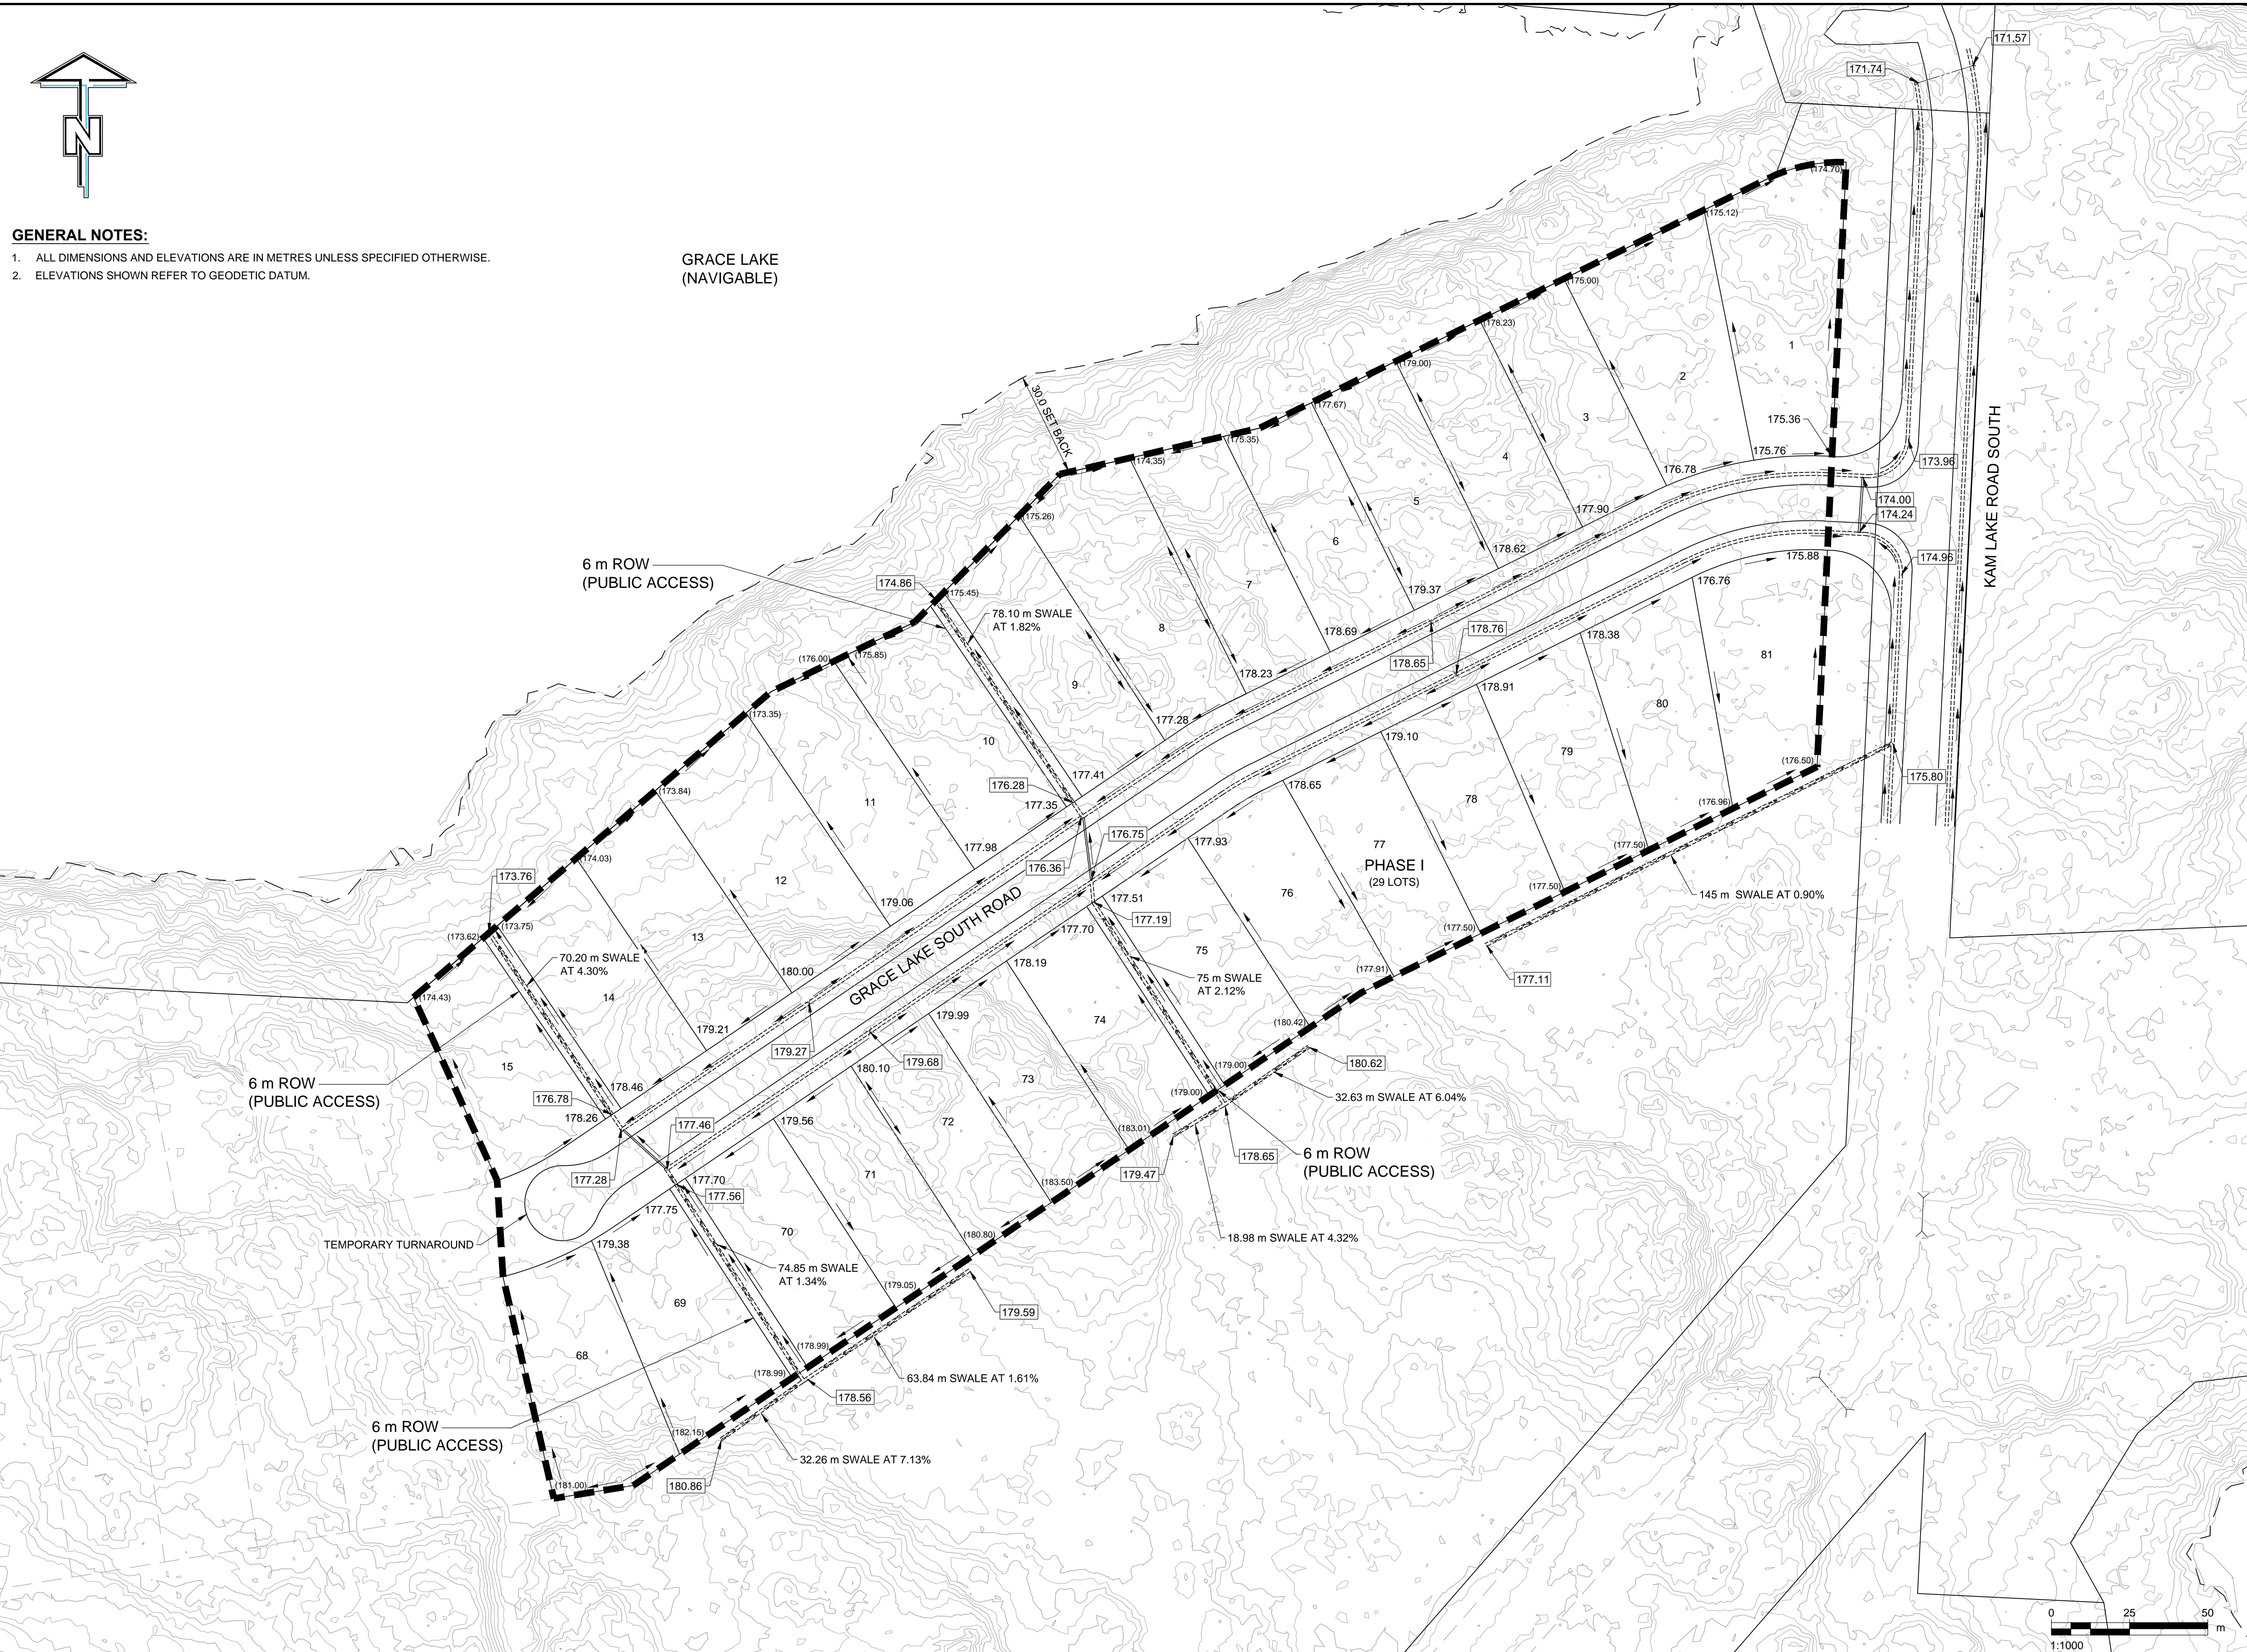

Project Management Initials: _____ Designer: _____ Checked: _____ Approved: _____
 ANSI D 864mm x 559mm
 Last saved by: TRUONGD(2016-12-19) Last Plotted: 2016-12-20
 Filename: P:60344217-SHT-00-WORK99-CAD20-SHEETS-C-1001-DWG
 I: DRAWINGS & XREFS\60344217-SHT-00-C-1001.DWG
 Printed on: 100% Post-Consumer Recycled Content Paper